


6 N. East Street
 Suite 300
 Frederick, Maryland 21701
 Telephone: 800.883.4631
 Fax/Email: 301.662.8632
 www.kingasbury.com

Copyright 2014
 King, Asbury & Associates, PC
 All Rights Reserved

AS-BUILT CONDITIONS AS OF 6.12.14

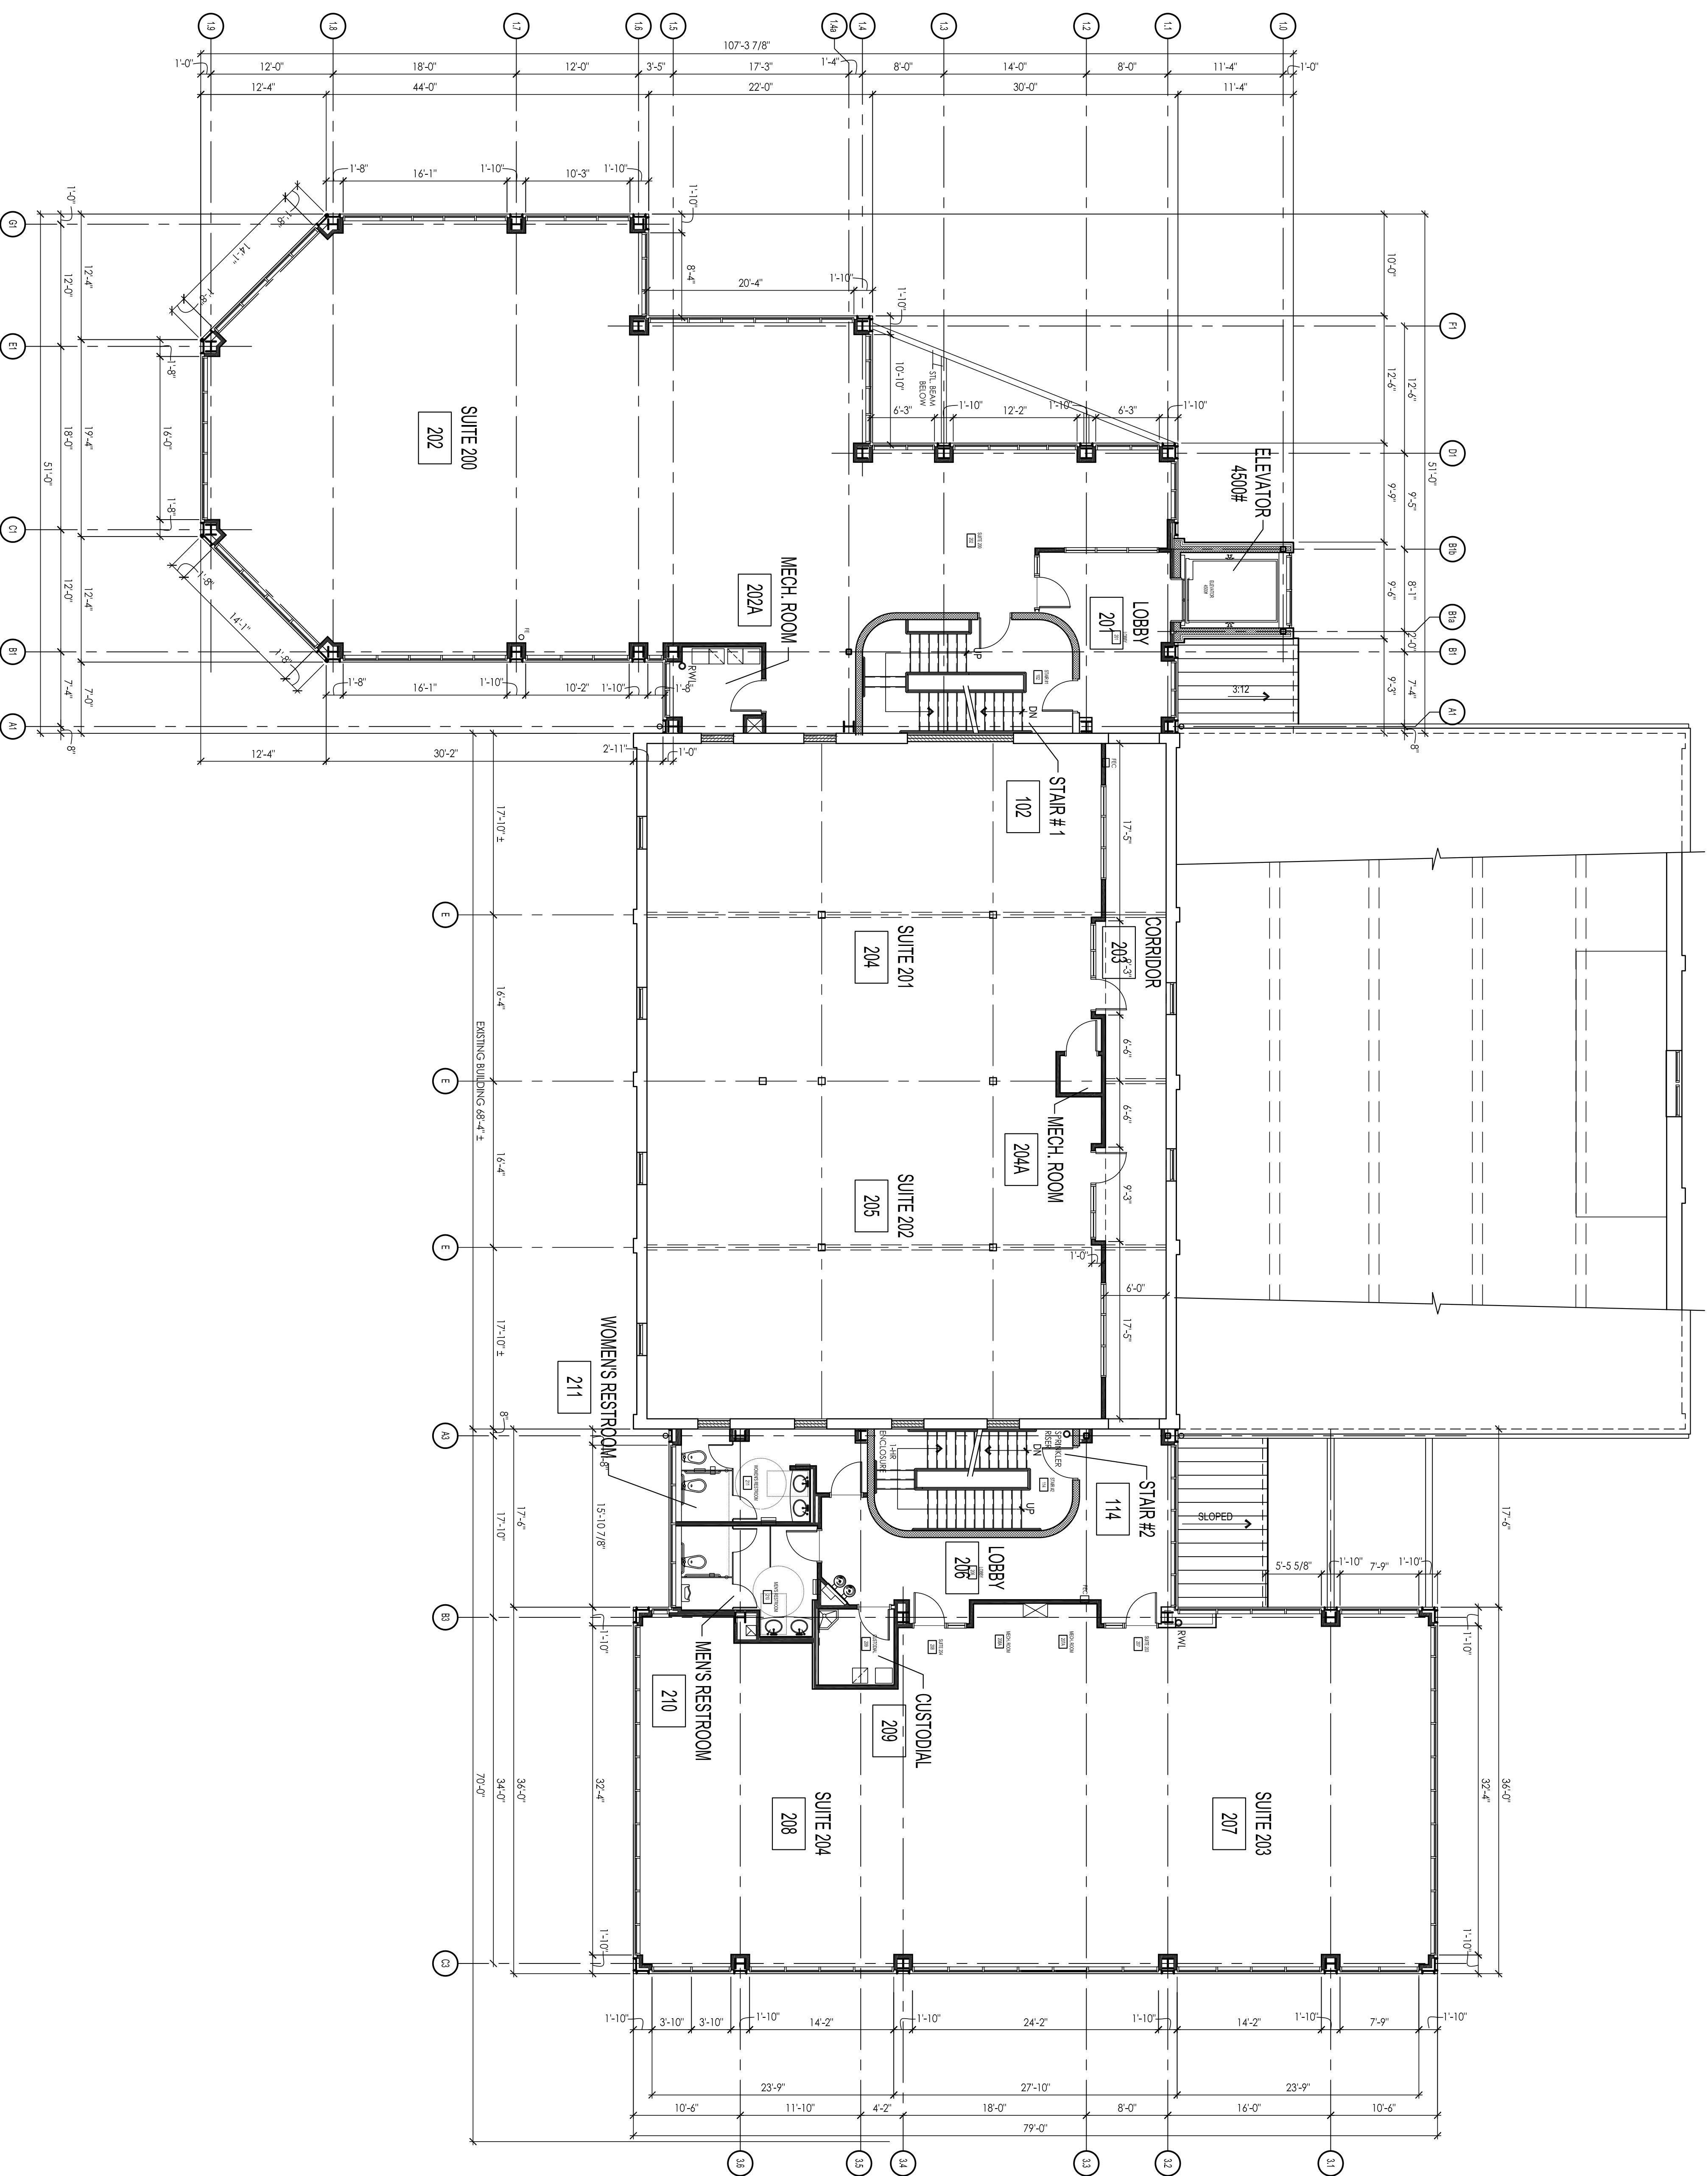

As-Builts
 for
Monocacy Canning Company
 150 S. East Street, Frederick, MD 21701
 SECOND FLOOR
 AS-BUILT PLANS

Commission Number:
 990270
 Drawn: LML
 Checked: THK
 Scale: 1/8" = 1'-0"
 Date: 10.29.14

A1.2