


6.1 East Street
 Suite 300
 Frederick, Maryland 21701
 Telephone 301 663 8451
 Facsimile 301 663 8632
 www.kingasbury.com

Copyright 2014
 King, Asbury & Associates, PC
 All rights reserved.

AS-BUILT CONDITIONS AS OF 6.12.14

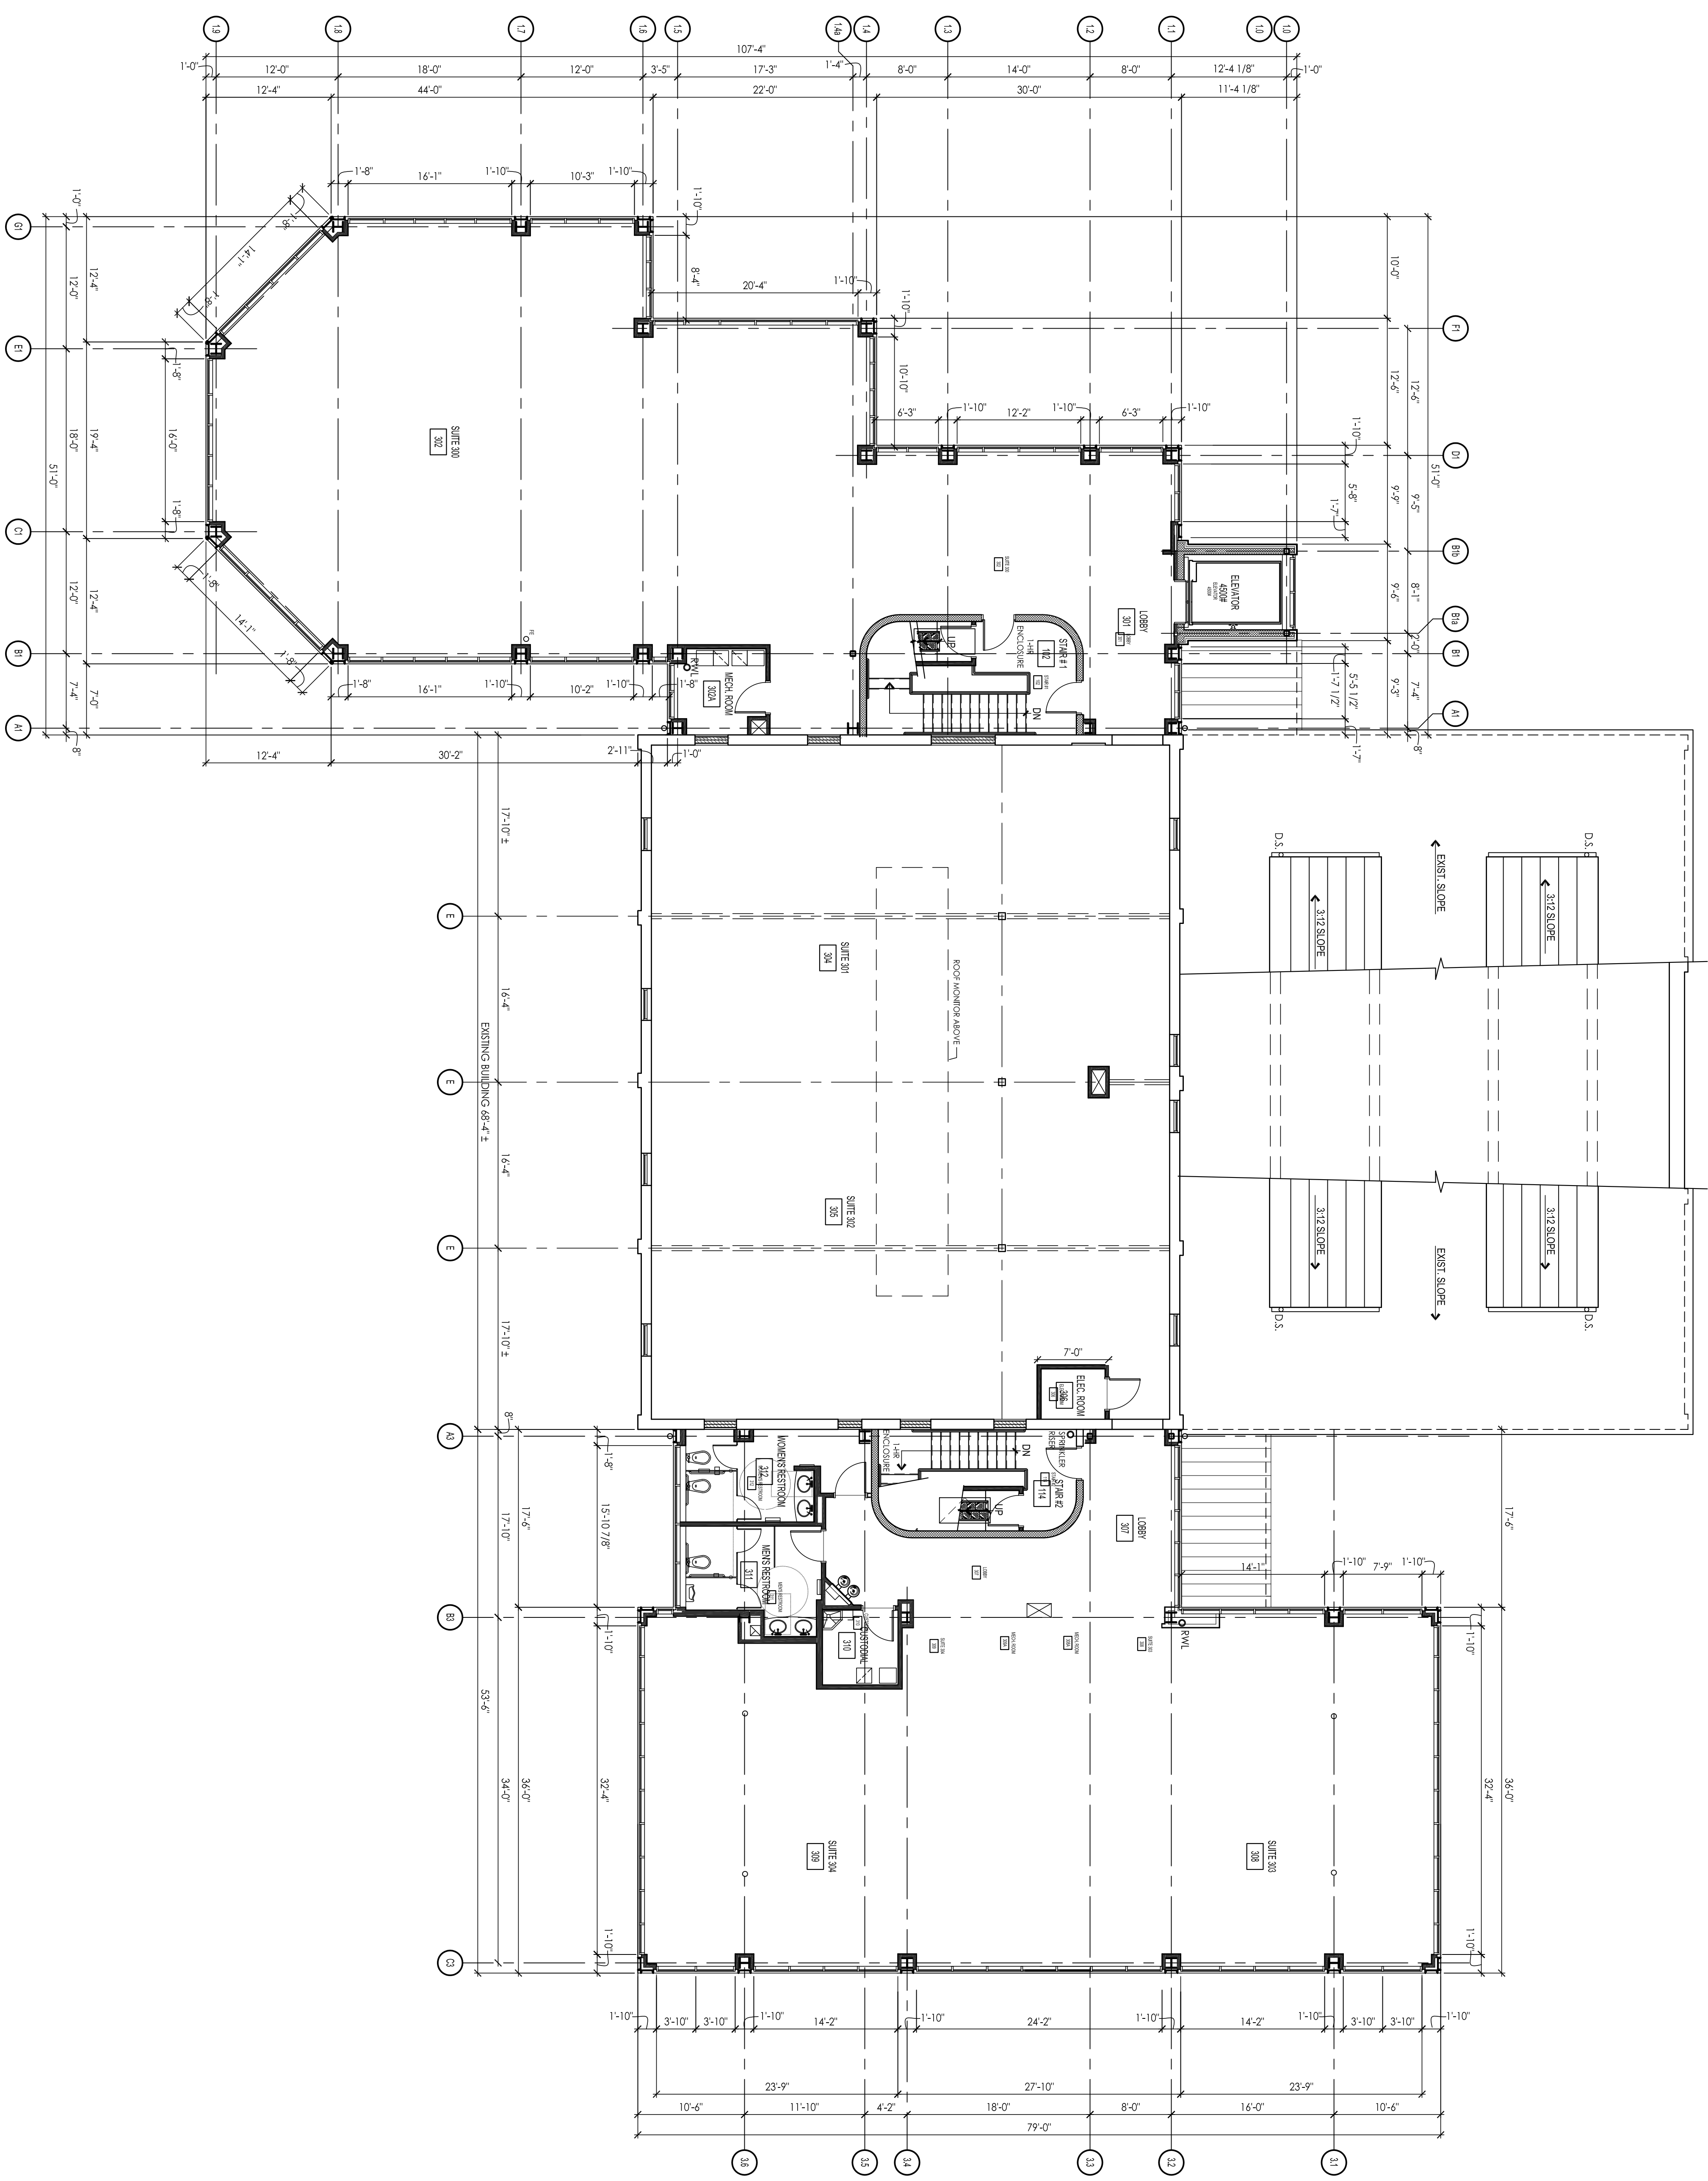

As-Builts
 for
Monocacy Canning Company
 150 S. East Street, Frederick, MD 21701
 THIRD FLOOR
 AS-BUILT PLANS

Commission Number:
 990270
 Drawn: LML
 Checked: THK
 Scale: 1/8" = 1'-0"
 Date: 10.29.14

A1.3